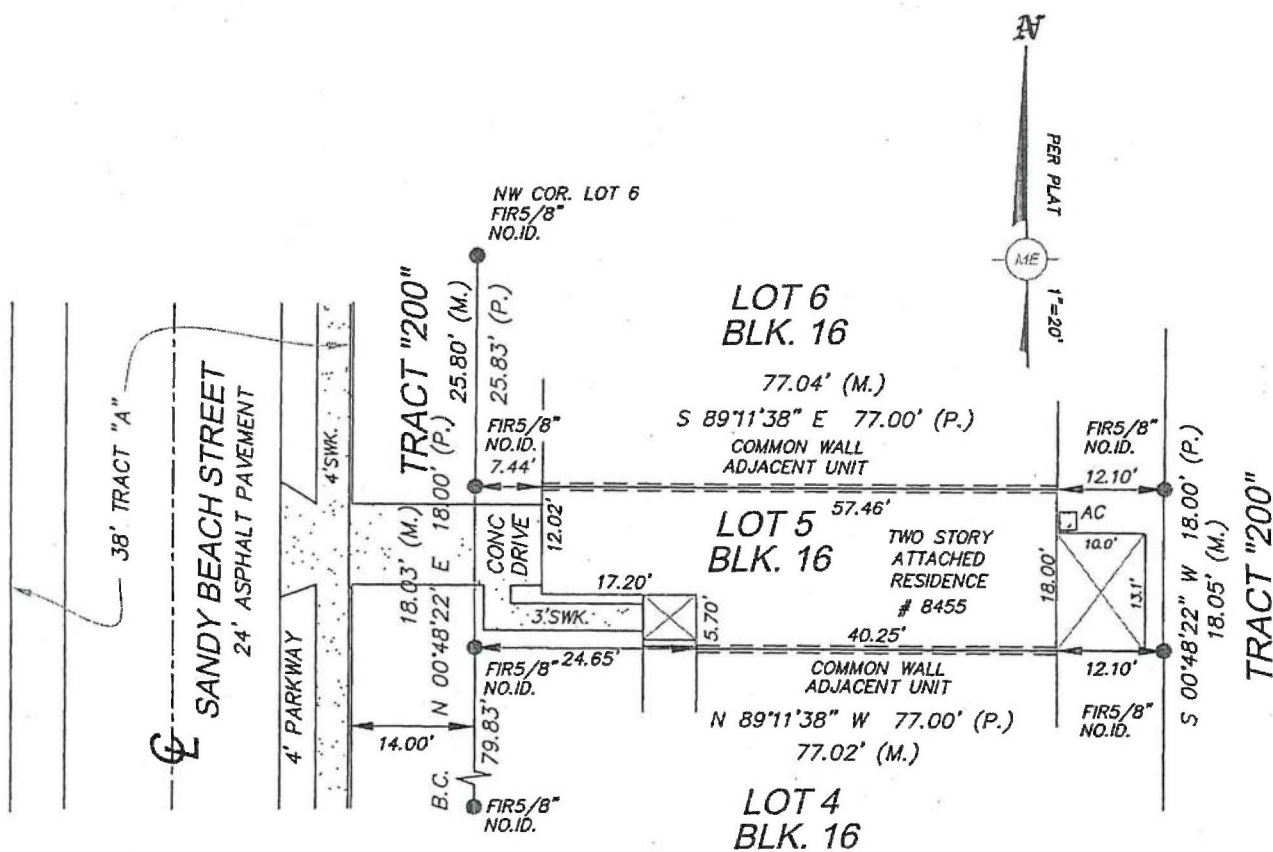




Proudly Serving
the Florida Real
Estate Community
for Over 20 Years

WWW.MELANDSERVICES.COM



Accepted By: [Signature]

Property Address:
8455 Sandy Beach Street
Tampa, FLORIDA 33634

Notes: NO NOTES

SURVEYOR'S CERTIFICATION: I HEREBY CERTIFY THAT THIS BOUNDARY SURVEY IS A TRUE AND CORRECT REPRESENTATION OF THE LAND SURVEYED UNDER MY SUPERVISION. THIS CERTIFICATE IS VALID FOR THE PURPOSES OF THE FLORIDA BOARD OF PROFESSIONAL LAND SURVEYORS. I AM A LICENSED SURVEYOR AND MAPPER IN THE STATE OF FLORIDA. EXPIRATION DATE: 12/31/2024.

SIGNED

EFRAIN LOPEZ
STATE OF FLORIDA




 
 








 
 
 

 



 

 


FOR THE FIRM

P.S.M. No. 6792

M.E. Land Surveying, Inc.
10665 SW 190th Street
Suite 3110
Miami, FL 33157
Phone: (305) 740-3319
Fax: (305) 669-3190
LB#: 7989



Surveyor's Legend

	PROPERTY LINE	FND	FOUND IRON PIPE / PIN AS NOTED ON PLAT	B.R.	BEARING REFERENCE	TEL.	TELEPHONE FACILITIES
	STRUCTURE	LB#	LICENSE # - BUSINESS		CENTRAL ANGLE OR DELTA	U.P.	UTILITY POLE
	CONC. BLOCK WALL	LS#	LICENSE # - SURVEYOR	R	RADIUS OR RADIAL	E.U.B.	ELECTRIC UTILITY BOX
	CHAIN-LINK FENCE OR WIRE FENCE	CALC	CALCULATED POINT	RAD.	RADIAL TIE	SEP.	SEPTIC TANK
	WOOD FENCE	SET	SET PIN	N.R.	NON RADIAL	D.F.	DRAINFIELD
	IRON FENCE		CONTROL POINT	TYP.	TYPICAL	A/C	AIR CONDITIONER
	EASEMENT		CONCRETE MONUMENT	I.R.	IRON ROD	S/W	SIDEWALK
	CENTER LINE		BENCHMARK	I.P.	IRON PIPE	DWY	DRIVEWAY
	WOOD DECK	ELEV	ELEVATION	N&D	NAIL & DISK	SCR.	SCREEN
	CONCRETE	P.T.	POINT OF TANGENCY	PK NAIL	PARKER-KALON NAIL	GAR	GARAGE
	ASPHALT	P.C.	POINT OF CURVATURE	D.H.	DRILL HOLE	ENCL.	ENCLOSURE
	BRICK / TILE	P.R.M.	PERMANENT REFERENCE MONUMENT		WELL	N.T.S.	NOT TO SCALE
	WATER	P.C.G.	POINT OF COMPOUND CURVATURE		FIRE HYDRANT	F.F.	FINISHED FLOOR
	APPROXIMATE EDGE OF WATER	P.R.C.	POINT OF REVERSE CURVATURE		M.H.	M.H.	MANHOLE
	COVERED AREA	P.O.B.	POINT OF BEGINNING	O.H.L.	OVERHEAD LINES	E.Q.W.	EDGE OF WATER
	TREE	P.O.C.	POINT OF COMMENCEMENT	TX	TRANSFORMER	E.O.P.	EDGE OF PAVEMENT
	POWER POLE	P.C.P.	PERMANENT CONTROL POINT	CATV	CABLE TV RISER	C.V.G.	CONCRETE VALLEY GUTTER
	CATCH BASIN	M	FIELD MEASURED	W.M.	WATER METER	B.S.L.	BUILDING SETBACK LINE
C.U.E.	COUNTY UTILITY EASEMENT	P	PLATTED MEASUREMENT	P/E	POOL EQUIPMENT	S.T.L.	SURVEY TIE LINE
I.E./E.E.	INGRESS / EGRESS EASEMENT	D	DEED	CONC.	CONCRETE SLAB		CENTER LINE
U.E.	UTILITY EASEMENT	C	CALCULATED	ESMT	EASEMENT	R/W	RIGHT-OF-WAY
		L.M.E.	LAKE OR LANDSCAPE MAINT. ESMT.	D.E.	DRAINAGE EASEMENT	P.U.E.	PUBLIC UTILITY EASEMENT
		R.O.E.	ROOF OVERHANG EASEMENT	L.B.E.	LANDSCAPE BUFFER EASEMENT	C.M.E.	CANAL MAINTENANCE EASEMENT
				L.A.E.	LIMITED ACCESS EASEMENT	A.E.	ANCHOR EASEMENT

Property Address:

8455 Sandy Beach Street
Tampa, FLORIDA 33634

Flood Information:

Community Number: 120112
Panel Number: 12057C0193H
Suffix: H
Date of Firm Index: 09/27/2013
Flood Zone: X
Base Flood Elevation:
Date of Field Work: 10/22/2017
Date of Completion: 10/25/2017

General Notes:

- 1.) The Legal Description used to perform this survey was supplied by others. This survey does not determine or is not to imply ownership
- 2.) This survey only shows above ground improvements. Underground utilities, footings, or encroachments are not located on this survey map
- 3.) If there is a septic tank, well, or drain field on this survey, the location of such items was shown to us by others and the information was not verified.
- 4.) Examination of the abstract of title will have to be made to determine recorded instruments, if any, effect this property. The lands shown herein were not abstracted for easement or other recorded encumbrances not shown on the plat
- 5.) Wall ties are done to the face of the wall.
- 6.) Fence ownership is not determined.
- 7.) Bearings referenced to line noted B.R
- 8.) Dimensions shown are platted and measured unless otherwise shown.
- 9.) No identification found on property corners unless noted.
- 10.) Not valid unless sealed with the signing surveyors embossed seal.
- 11.) Boundary survey means a drawing and/or graphic representation of the survey work performed in the field, could be drawn at a shown scale and/or not to scale
- 12.) Elevations if shown are based upon NGVD 1929 unless otherwise noted
- 13.) This is a BOUNDARY SURVEY unless otherwise noted.
- 14.) This survey is exclusive for the use of the parties to whom it is certified. The certifications do not extend to any unnamed parties.
- 15.) This survey shall not be used for construction/permitting purposes without written consent from the land surveyor who has signed and sealed this survey.

Legal Description:

Lot 5, of Block 16, of SOLANA BAY, according to the plat thereof, as recorded in Plat Book 100, Page 81 through 89, inclusive, of the public records of Hillsborough County, FLORIDA

Printing Instructions:

While viewing the survey in any PDF Reader, select the File Drop-down and select "Print". Select a color printer, if available; or at least one with 8.5" x 14" (legal) paper. Select ALL for Print Range, and the # of copies you would like to print out. Under the "Page Scaling" please make sure you have selected "None". Do not check the "Auto-rotate and Center" box. Check the "Choose Paper size by PDF" checkbox, then click OK to print.

Certified To:

Matthew Lee Miller
All About Title, LLC
First American Title Insurance Company
SunTrust Mortgage, Inc.
its successors and/or assigns as their interest may appear.

Please copy below for policy preparation purposes only:

This policy does not insure against loss or damage by reason of the following exceptions: Any rights, easements, interests, or claims which may exist by reason of, or reflected by, the following facts shown on the survey prepared by
EFRAIN LOPEZ dated 10/25/2017 bearing Job # B-34232 :
a. NO NOTES



M.E. Land Surveying, Inc.

10665 SW 190th Street, Suite 3110 Miami, FL 33157
Phone: (305) 740-3319
Fax: (305) 669-3190
LB#: 7989

